


DEPARTMENT OF THE ARMY  
FIRST AMENDMENT TO PERMIT

The Permit granted to the Department of the Air Force on 20 September 1957 for use and occupancy for Air Force purposes of the Army Installation known as the Seattle Transportation Corps Storage Site, 4500 East Marginal Way, Seattle, King County, Washington, is hereby amended in the following respects:

- a. By inserting the word "Revised" before the words "Exhibit "B" in line 8 of the granting clause of said Permit.
- b. By substituting the attached "Revised Exhibit "B" for Exhibit "B" attached to said Permit.
- c. By inserting the word "Revised" before the words "Exhibit "C" in line 17 of the granting clause of said Permit.
- d. By deleting the words "in all 370' x 250'" in line 16 of the granting clause of said Permit and inserting in lieu thereof the following:  
" , designated as Parcel "A", and Parcel "B", both shown by green outline on attached "Revised Exhibit "B".

Said Permit of 20 September 1957 remains in full force and effect and unchanged in all other respects.

IN WITNESS WHEREOF I have hereunto set my hand by authority of the  
Secretary of the Army this 27th day of March 1958.

  
R. J. B. PAGE  
Colonel, Corps of Engineers  
District Engineer

1 10 2-28-58  
RECORD COPY

# BUILDING LEGEND



SAGE

B.D.G.  
NO

USAGE

LUMBER STORAGE SHED  
LUMBER STORAGE SHED  
GUARD HOUSE  
GUARD HOUSE  
WAREHOUSE & OFFICE  
OIL STORAGE SHED

T-137 PAINT STORAGE SHED  
T-138 GUARD HOUSE  
140 WAREHOUSE  
150 WAREHOUSE  
154 INFLAMMABLE MATERIALS STORAGE

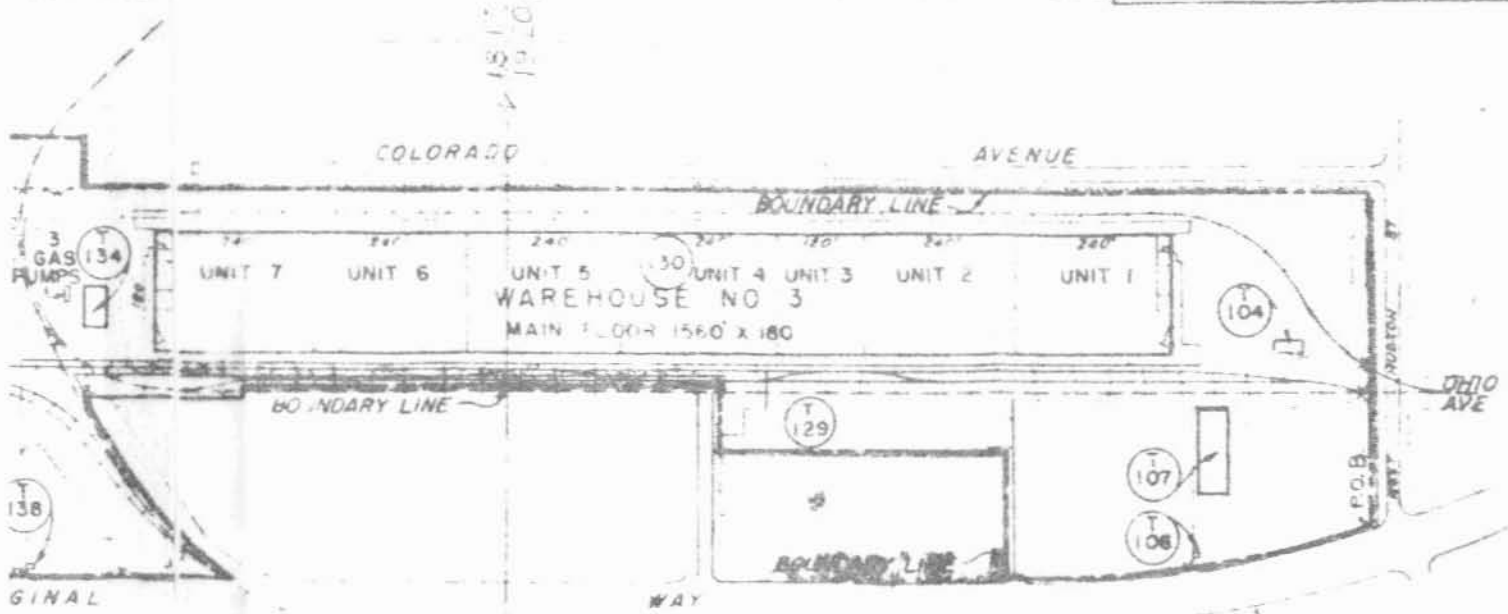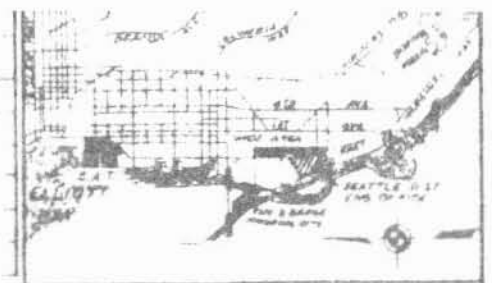

## LEGEND

RY LINE  
LINE  
MENT-OWNED TRUCKAGE  
RAILROAD TRUCKAGE  
G NUMBER  
TION WHSE. 5  
LS A & B PERMITTED  
ALTH, EDUCATION AND  
RE

Revise 16 Aug 57

SE-RE 3674 A

## LAND MANAGEMENT MAP

DEPARTMENT OF THE ARMY  
OFFICE OF THE SEATTLE DISTRICT ENGINEER  
NORTH PACIFIC DIVISION

## REAL ESTATE

SEATTLE TRANSPORTATION CORPS  
STORAGE SITE

REVISED EXHIBIT "B"  
MILITARY RESERVATION